
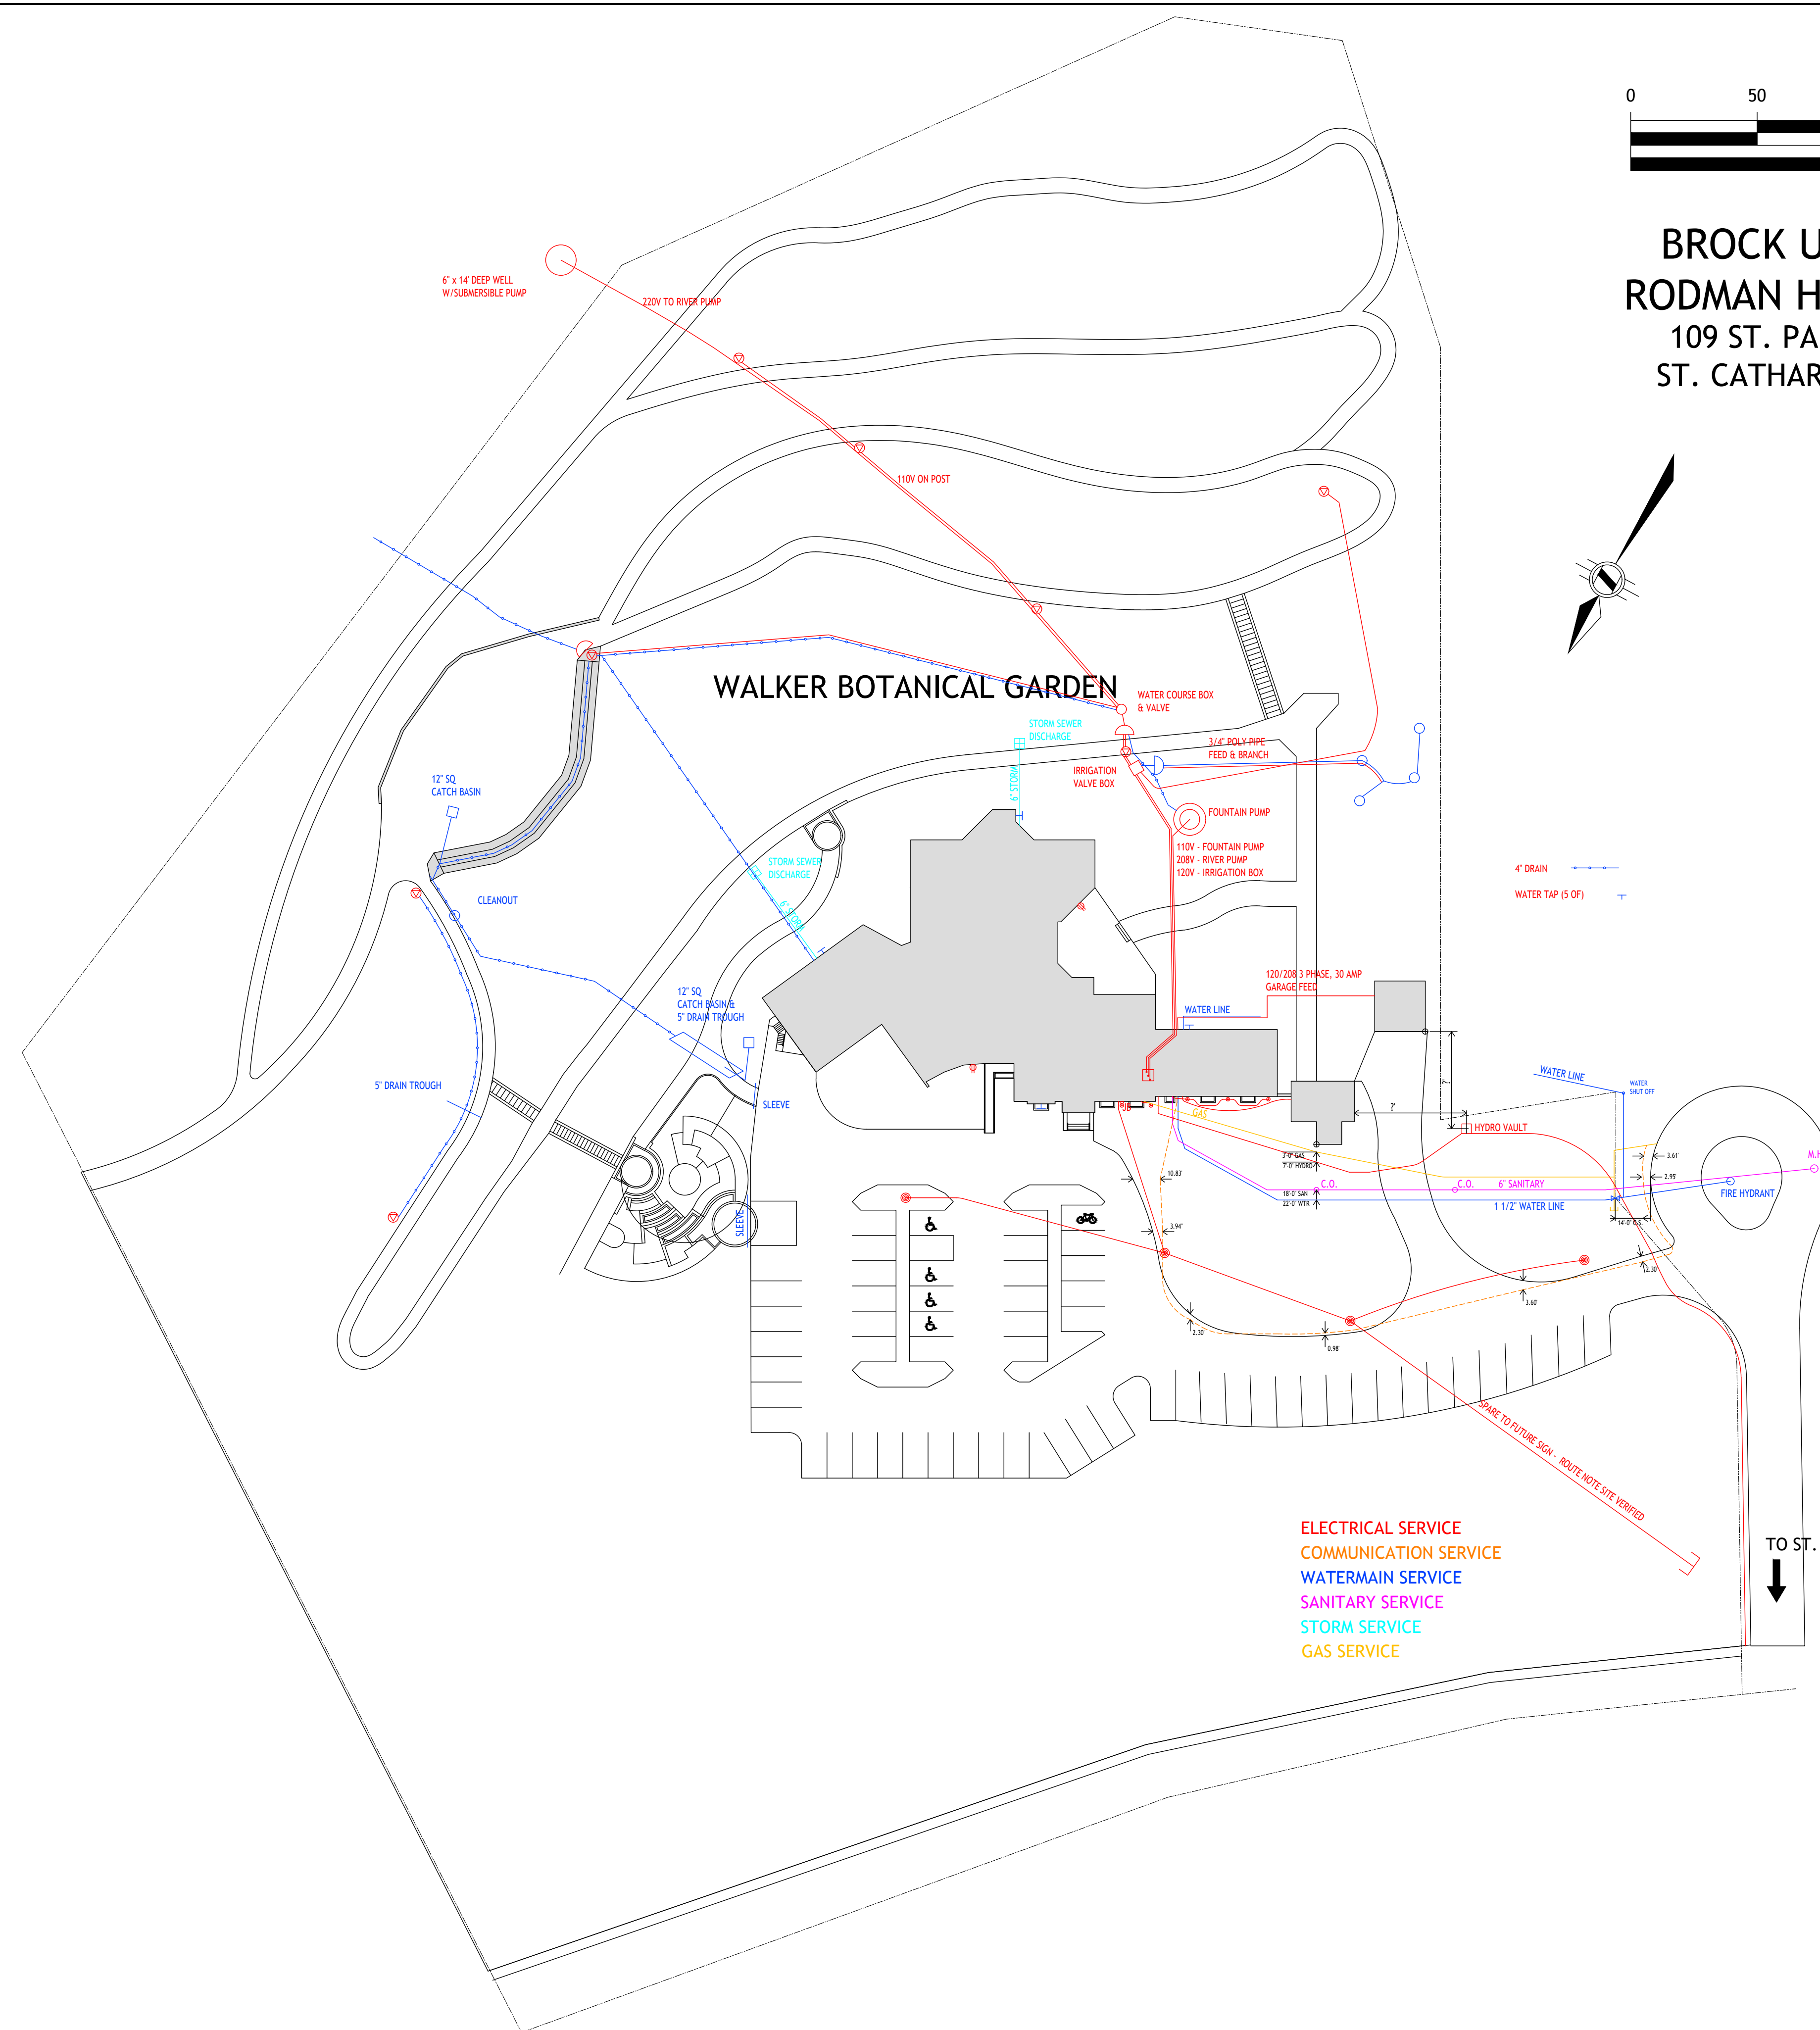


**BROCK UNIVERSITY  
RODMAN HALL CAMPUS**  
109 ST. PAUL CRESCENT  
ST. CATHARINES ONTARIO

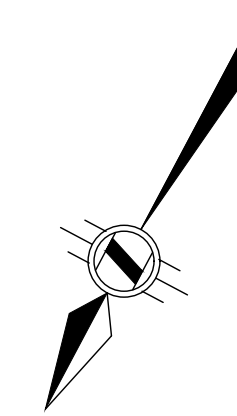

**ELECTRICAL SERVICE**  
**COMMUNICATION SERVICE**  
**WATERMAIN SERVICE**  
**SANITARY SERVICE**  
**STORM SERVICE**  
**GAS SERVICE**

	FILE NO.:	RH-SITE
	SCALE:	.....
	DRAWN BY:	P.WAKE

**RODMAN HALL**  
SITE PLAN

**BROCK UNIVERSITY**  
FACILITIES MANAGEMENT  
ST. CATHARINES, ONTARIO L2S 3A1

RECORD DRAWING