


	FILE NO.:	RH-02
	SCALE:	1/16" = 1'-0"
	DRAWN BY:	P. WAKE

RODMAN HALL
LEVEL 200

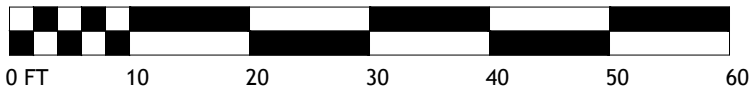

BROCK UNIVERSITY
FACILITIES MANAGEMENT
ST. CATHARINES, ONTARIO L2S 3A1

RECORD DRAWING

WHEN ONLY 1 DOOR TO ACCESS A ROOM
EXISTS THE DOOR NUMBER WILL BE THE
SAME AS THE ROOM NUMBER