


	FILE NO.:	RH-03
	SCALE:	1/16" = 1'-0"
	DRAWN BY:	P. WAKE

**RODMAN HALL  
LEVEL 300**

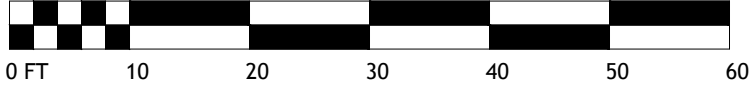

**BROCK UNIVERSITY**  
**FACILITIES MANAGEMENT**  
 ST. CATHARINES, ONTARIO L2S 3A1

**RECORD DRAWING**