


	FILE NO.:	RH-00
	SCALE:	1/16" = 1'-0"
	DRAWN BY:	P. WAKE

**RODMAN HALL  
LEVEL BASEMENT**

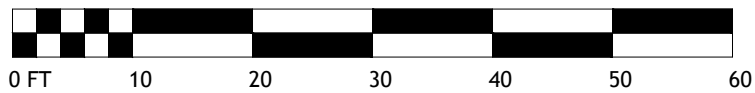

**BROCK UNIVERSITY  
FACILITIES MANAGEMENT  
ST. CATHARINES, ONTARIO L2S 3A1**

**RECORD DRAWING**