


**BROCK UNIVERSITY**  
**FACILITIES MANAGEMENT**  
 ST. CATHARINES, ONTARIO L2S 3A1

**RECORD DRAWING**

**GOODMAN SCHOOL OF BUSINESS**  
**LEVEL 300**

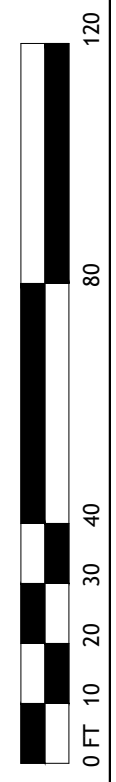

FILE NO.:	G5B-03
SCALE:	1/32" = 1'-0"
DRAWN BY:	P. WAKE