


BROCK UNIVERSITY
FACILITIES MANAGEMENT
 ST. CATHARINES, ONTARIO L2S 3A1

RECORD DRAWING

MACKENZIE CHOWN COMPLEX BLOCK 'A'
LEVEL 300

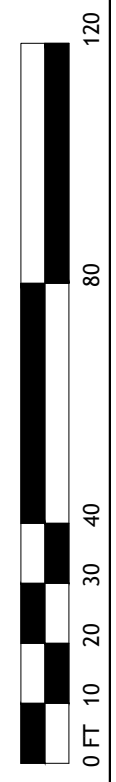

FILE NO.:	MCA-03
SCALE:	1/32" = 1'-0"
DRAWN BY:	P. WAKE